


REVISIONS	DATE	MARK	NATURE	MADE	CHK'D	REV'D

Z:\2025 Projects\25002 - 2025 PDD Projects\Plans\21st Ave S btwn S Walker St and S Bayview St\25002_P-GRAD-21stAveS.dwg
Jul-27-25 3:16pm

MATCH LINE - SEE SHEET PV03

MATCH LINE - SEE ABOVE RIGHT

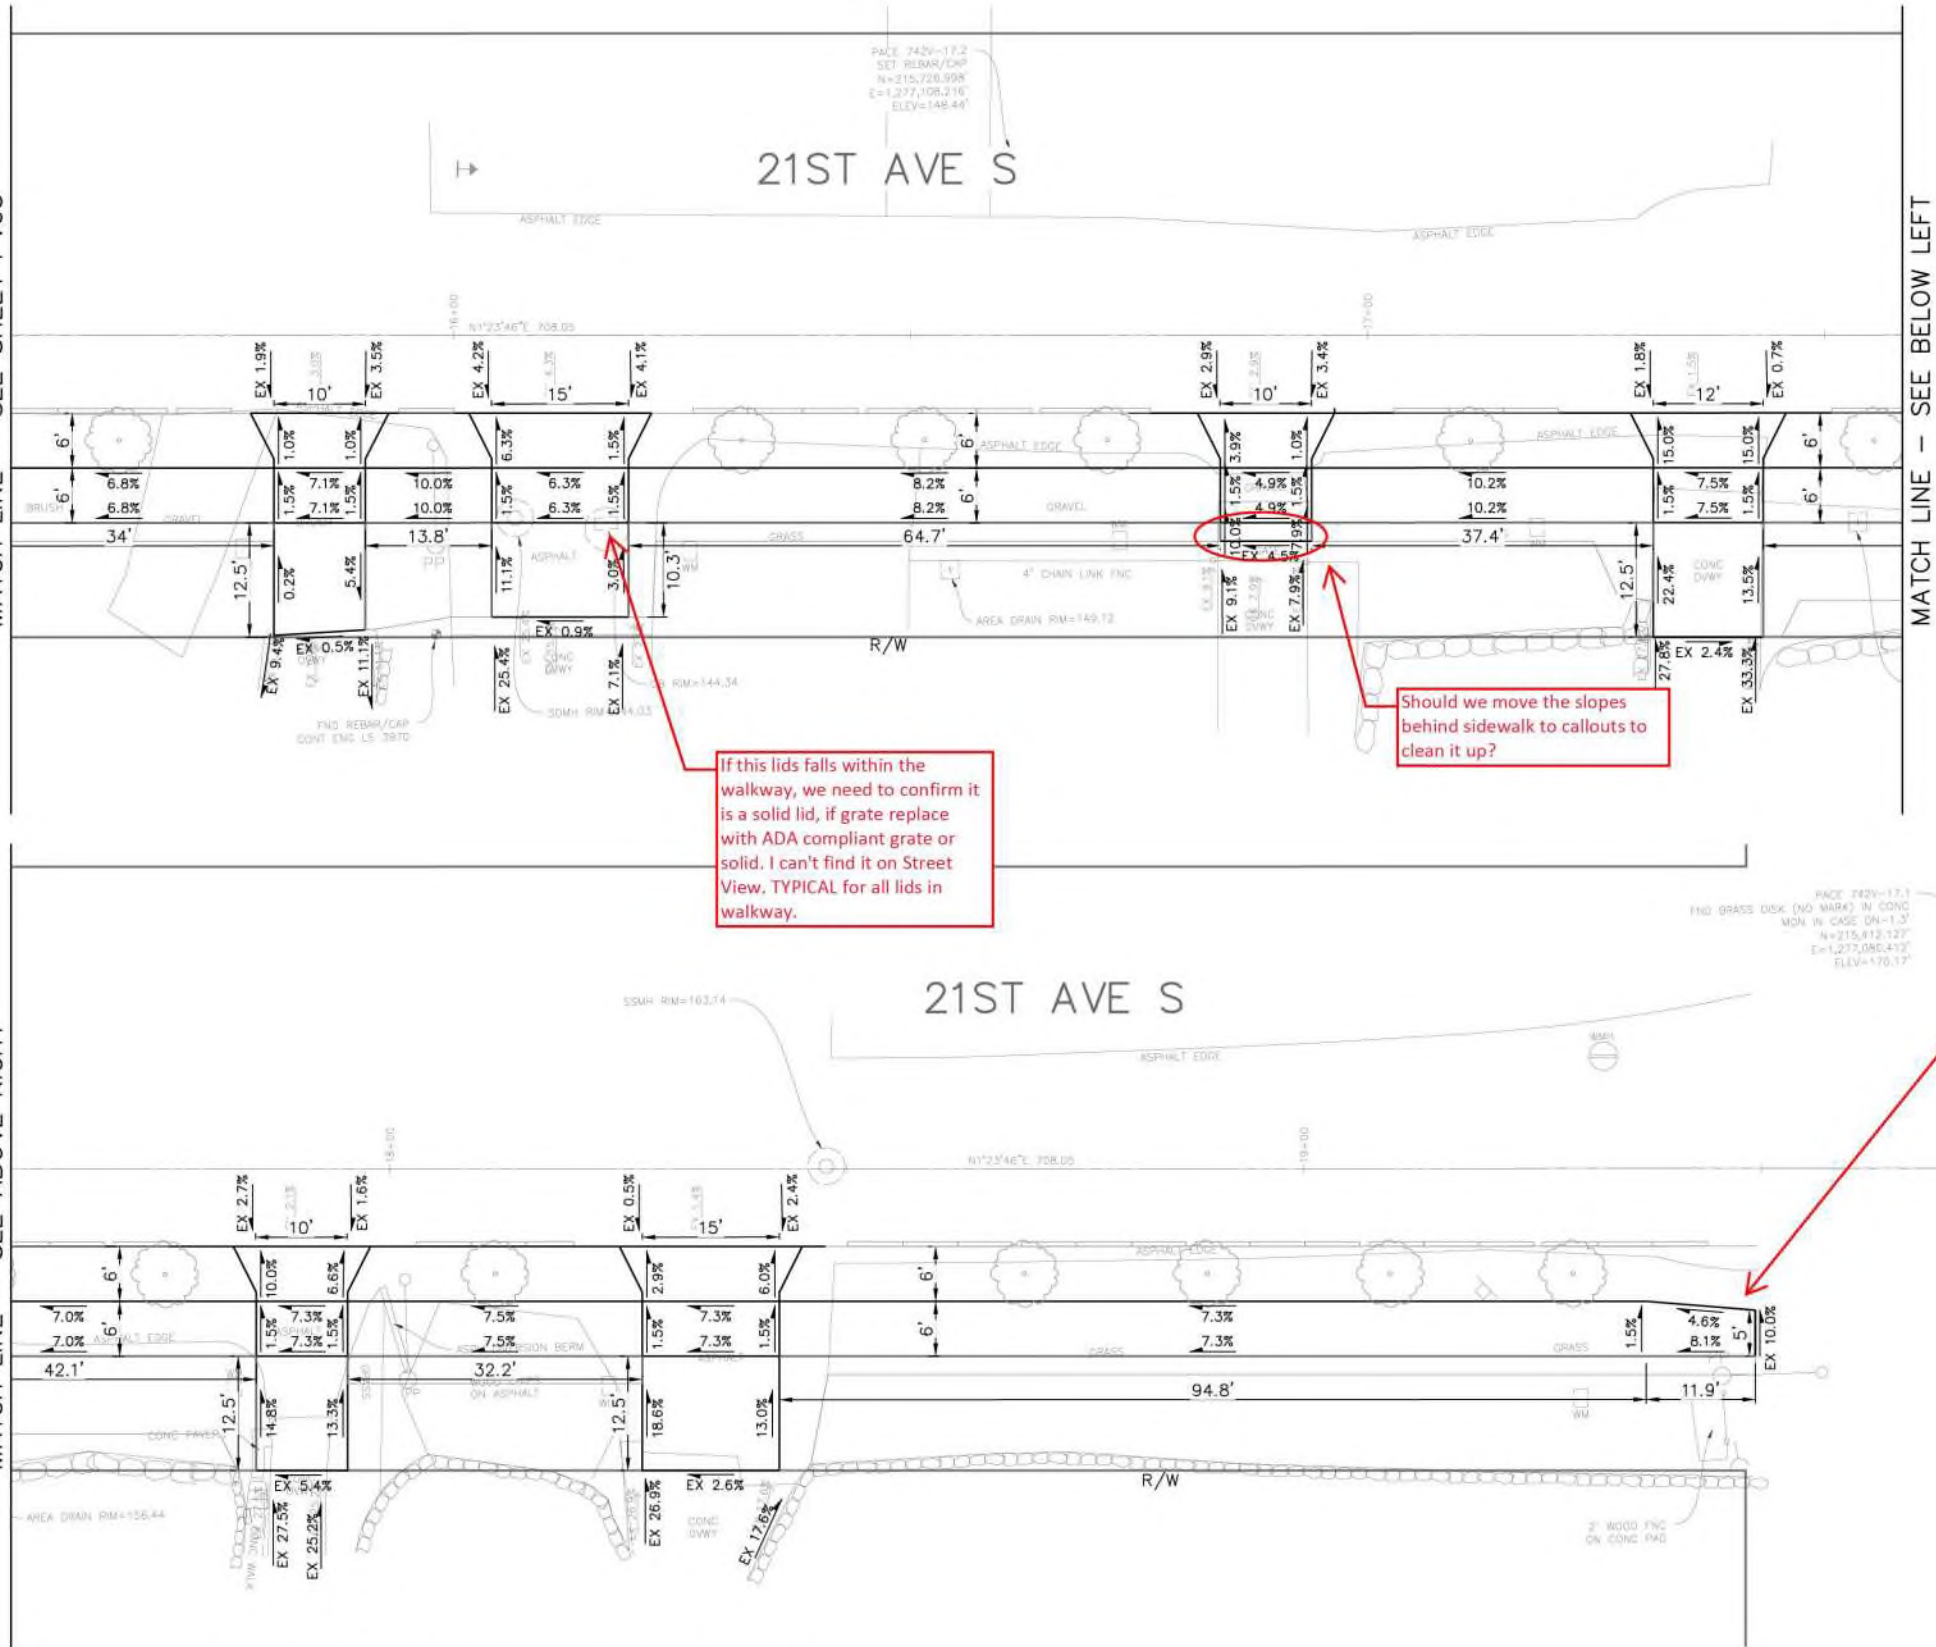

If this lids falls within the walkway, we need to confirm it is a solid lid, if grate replace with ADA compliant grate or solid. I can't find it on Street View. TYPICAL for all lids in walkway.

Should we move the slopes behind sidewalk to callouts to clean it up?

Would matching here preclude from building a compliant future curb ramp? Should we match into the landing of the new curb ramp instead? I would ask for an eastbound curb ramp here, but unless we allow a deviation, it will trigger a companion curb ramp, it is less than 36" wide and greater than 12.5% and eventually all the way around. This ramp was built by a utility (since at least 2021) and lost in the system and just inspected last week. Can the project please design a curb ramp matching into the existing new landing and one showing what the ramp would be if it will have to match the proposed walkway as shown to the right? I'm assuming we have survey, it can be CAD screenshots, it will help decide if we will push for one option or the other. We can discuss if necessary.



90% SUBMITTAL (NOT FOR CONSTRUCTION)

GRADING
21ST AVE S BTWN S WALKER ST & S BAYVIEW ST

 1221 East Pike St, Suite 201 Seattle, WA 98122 206-669-0612	APPROVED FOR ADVERTISING FAS PURCHASING AND CONTRACTING DIRECTOR SEATTLE, WASHINGTON BY: _____ FAS PURCHASING AND CONTRACTING DIRECTOR	INITIALS AND DATE DESIGNED: FGC CHECKED: CEM DRAWN: FGC CHECKED: CEM	INITIALS AND DATE REVIEWED: DES. CONST. SDOT PROJ. MGR. RECEIVED REVISED AS BUILT	 OFFICIAL SEAL	 ORDINANCE NO. _____ PW NO. _____ SCALE: 1"=10'	2025 PDD PROJECTS	PC CO VPI # GD04 SHEET 13 OF 14
---	--	--	---	-------------------	--	-------------------	---